

A000509670

OFFICE OF COUNTY RECORDER  
CASS COUNTY MINNESOTA

CERTIFIED, FILED, AND/OR  
RECORDED ON  
02/08/2006 11:46:09AM

AS DOC #: A000509670  
PAGES: 2  
REC FEES: \$0.00

KATHRYN M. NORBY  
COUNTY RECORDER


BY *Kathryn M. Norby*

# CERTIFICATE OF LOCATION OF GOVERNMENT CORNER

Northeast Corner of Section 27, Township 134, Range 31  
West Principal Meridian, State of Minnesota, County of Cass

At the corner location shown on the sketch:

- On \_\_\_\_\_ found a \_\_\_\_\_
- left monument as found     lowered monument     removed monument (explain)
- On 12/14/05 placed a 1/2" iron pipe monument capped RLS 42619

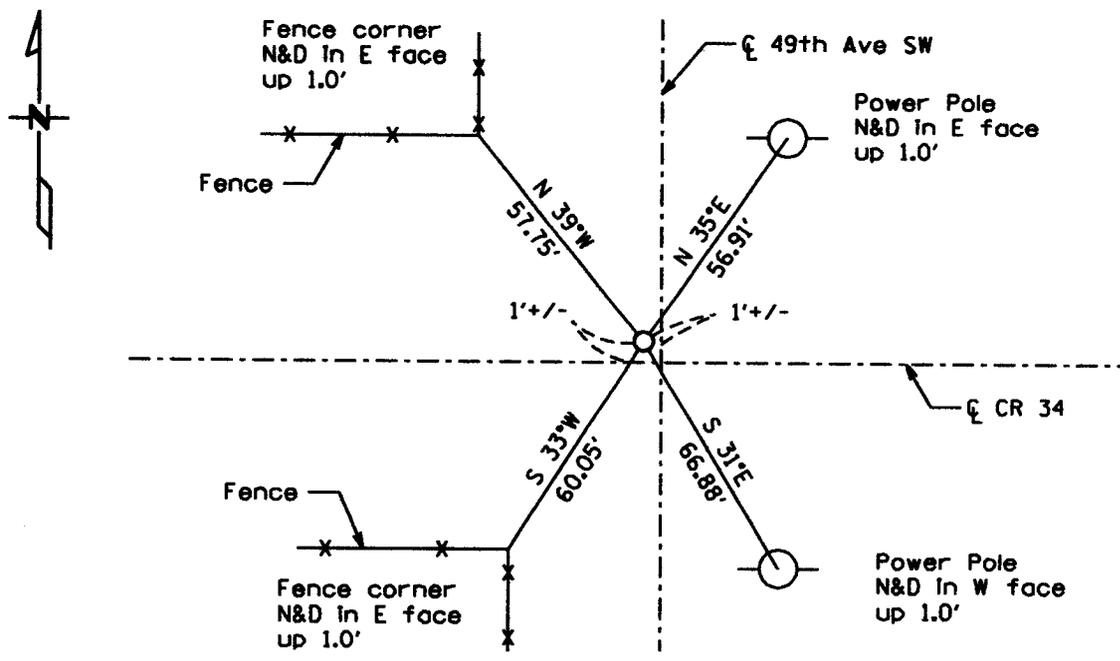

Statement of evidence for this corner location is on back of this page.

I hereby certify that this document was researched and prepared by me or under my direct supervision.

Signature *Justin Lee*      Date 12/15/05      License No. 42619

Titles:     Land Surveyor     Professional Engineer     County Surveyor     County Engineer

**Statement of Evidence:**

**Northeast Corner Section 27, Township 134 North, Range 31 West**

**The Original Public land survey was run in 1869 and a wood post was set to mark the corner. Bearing tree ties were made to two Oak trees, an Aspen, and an Ironwood.**

**In 1907 Mr. John Curo set an 8X8 stone monument. Bearing tree ties were made to an Oak Stump and a Red Oak.**

**In 1985 Mr. Terry Freeman researching the corner, discovered in Highway Department road plans a cut sufficient to remove stone monument, no other evidence was recovered at that time.**

**In 2005 Kramer Leas DeLeo searched for corner evidence, and nothing was found. John Curo's 1907 distances were used for search, distances between modern monuments and Curo's noted distances varied and no index was evident. KLD positioned intersecting road centerlines and nearby fence corners, computed a double proportion lost position, and checked against the Curo distances. The lost position and the occupation position are a close match, also lending credence to the Curo distances. This is the position that KLD holds as the true position. KLD placed a ½" iron pipe monument capped RLS 42619 and made bearing tree ties to two fence corners and two power poles. Kramer Leas DeLeo accepts this as the correct location for the corner.**

**For details and survey analysis contact Kramer Leas DeLeo in Brainerd, Minnesota.**