

A000509690

OFFICE OF COUNTY RECORDER
CASS COUNTY MINNESOTA

CERTIFIED, FILED, AND/OR
RECORDED ON
02/08/2006 11:46:29AM

AS DOC #: A000509690
PAGES: 2
REC FEES: \$0.00

KATHRYN M. NORBY
COUNTY RECORDER


BY *Kathryn M. Norby* ^{AV} DEPUTY

CERTIFICATE OF LOCATION OF GOVERNMENT CORNER

Northeast Corner of Section 35, Township 138, Range 30
West Principal Meridian, State of Minnesota, County of Cass

At the corner location shown on the sketch:

- On 3/24/05 found a Cast iron monument
DATE
- left monument as found lowered monument removed monument (explain)
- On _____ placed a _____
DATE

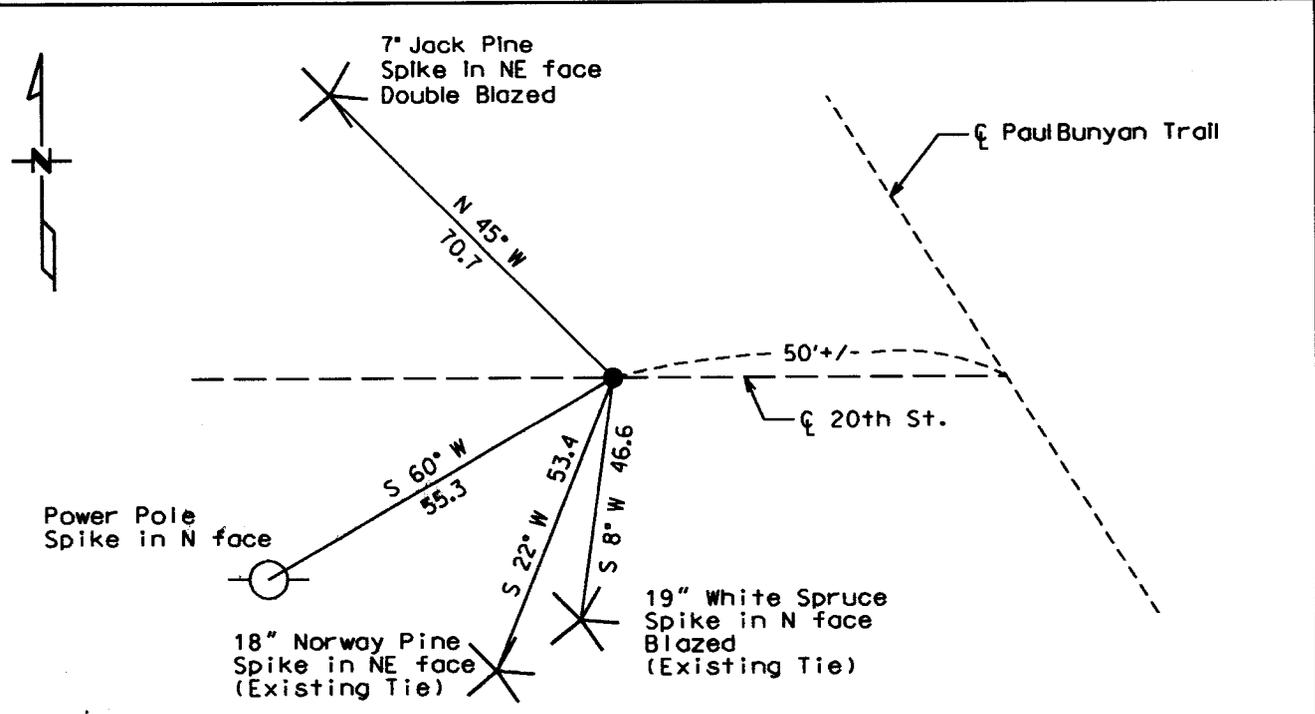

Statement of evidence for this corner location is on back of this page.

I hereby certify that this document was researched and prepared by me or under my direct supervision.

Signature *J. M. Lee* Date 7/28/05 License No. 42619
 Title: Land Surveyor Professional Engineer County Surveyor County Engineer

Statement of Evidence:

Northeast Corner Section 35, Township 138 North, Range 30 West

The Original Public Land Survey was run in 1865 and a wood post was set to mark the corner. Bearing tree ties were made to a Norway Pine and a Black Pine.

In 1908 Mr. John Curo set a 1" iron pipe monument. Bearing tree ties were made to a Jack Pine.

In 1965 Mr. R.F. Schneider recovered an iron pipe monument. Bearing tree ties were made to two Jack Pines and a White Oak.

In 1981 Mr. Myron Landecker shows the monument recovered in the plat of Golf View Estates.

In 2004 Mr. Bruce Grivna shows the monument recovered on a Certificate of Survey.

In 2005 Kramer Leas DeLeo recovered a cast iron monument and made bearing tree ties to a Jack Pine, a Power Pole, a Norway Pine and a White Spruce. Kramer Leas DeLeo accepts this position as the correct location for the corner.

For details and survey analysis contact Kramer Leas DeLeo in Baxter, Minnesota.