

# CERTIFICATE OF LOCATION OF GOVERNMENT CORNER


Northeast Corner of Section 21, Township 134N., Range 31W., 5th P.M.

STATE OF MINNESOTA, County of Cass

At the corner location shown on the sketch:

- On 7/2/86 found a 8"x 8"x 36" stone with concrete pieces around the base.
  - left monument as found,  lowered monument,  removed monument (explain)
- On 10/16/86 placed a 1 1/2"x 18" iron pipe on north side and 1 1/2"x 2.5' iron pipe on the south side of found stone.

SKETCH OF REFERENCE TIES

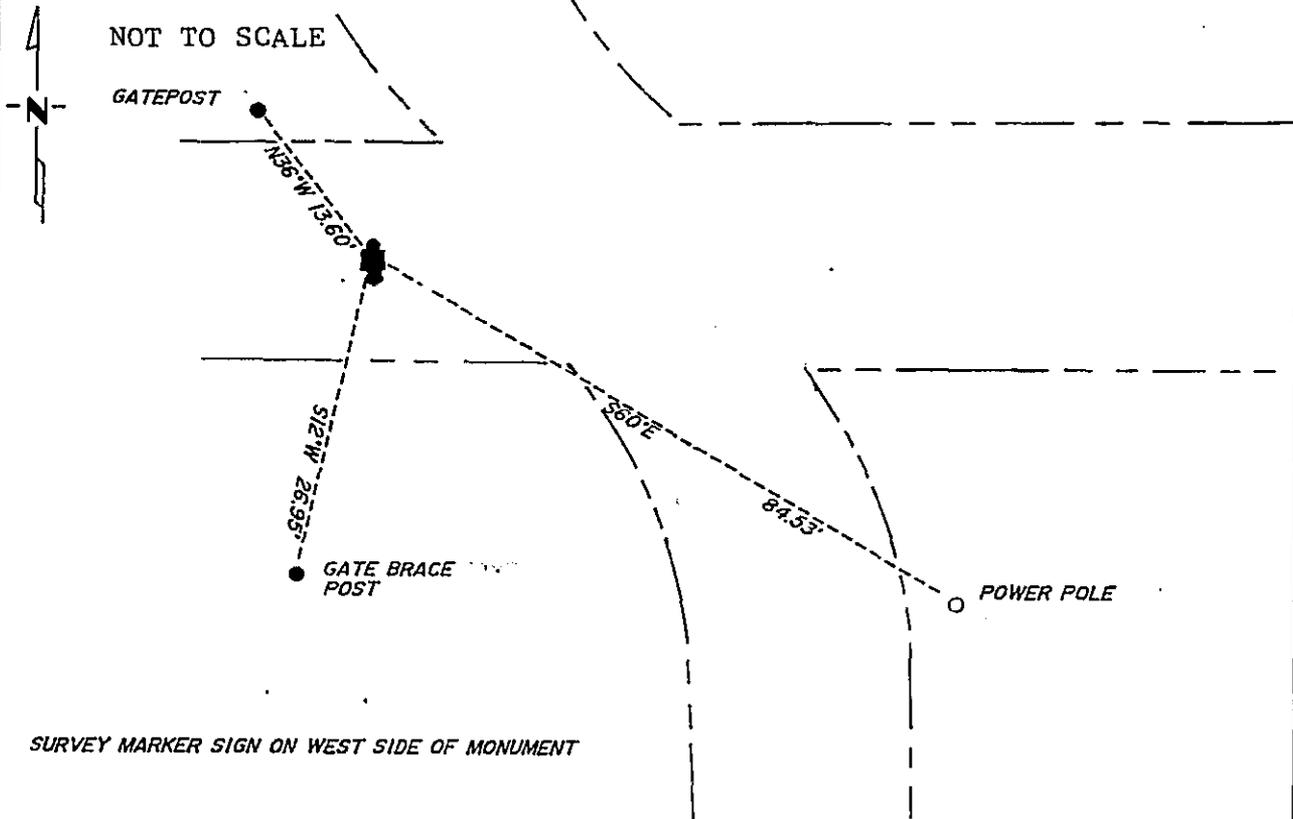

Statement of evidence relative to this corner location is on back of page. 319098

I hereby certify that this document and the data contained herein was prepared by me or under my direct supervision.

Walt P. Olson SIGNATURE      3-15-90 DATE

Registration No. 11395

- Land Surveyor
- County Surveyor

OFFICE OF THE COUNTY RECORDER

County of Cass

I hereby certify that this document was filed in the Co. Recorders office at 3:45 P.M. on the 19 day of March A.D., 19 90

County Recorder Claudine Kayler

By ms, Deputy

DOCUMENT NO. 319098

Northeast Corner, Section 21, T134N., R.31W., 5th P.M.

- 1869 U.S. General Land Office survey set a wood post for this corner and marked the following bearing trees: a 3" Aspen N62W 18 links, a 3" Aspen S43W 20 links, and a 2" Aspen N16E 13 links.
- 1910 County Survey Record Book "A", pages 56-57 show a survey by John Curo. He set an 8"x 8"x 36" stone.
- 1915 County Survey Record Book "B", pages 490-495, show a survey by N.D. Gorman. He found the corner.
- 1985 On November 7, Cass County Survey Technician Terry Freeman talked to local resident Elven Martin who said the road to north of corner was built on the section line.
- 1986 On July 2, Terry Freeman and backhoe operator Glen Williams found 8" square stone monument with pieces of concrete around the base and with the top flush with the ground. It was located east of the culvert.
- 1986 On October 16, Terry Freeman placed a 1½" x 1½' iron pipe on the north side and a 1½" x 2½' iron pipe on the south side of the stone that was found.