

A000518633

OFFICE OF COUNTY RECORDER  
CASS COUNTY MINNESOTA

CERTIFIED, FILED, AND/OR  
RECORDED ON  
10/05/2006 08:23:10AM

AS DOC #: A000518633  
PAGES: 2  
REC FEES: \$0.00

KATHRYN M. NORBY  
COUNTY RECORDER


BY Kathryn Norby DEPUTY

# CERTIFICATE OF LOCATION OF GOVERNMENT CORNER

Northeast Corner of Section 1, Township 133, Range 32  
West Principal Meridian, State of Minnesota, County of Cass

At the corner location shown on the sketch:

- On 6/20/06 found a Telspar Monument with aluminum cap on  
DATE centerline of County Road #33
- left monument as found     lowered monument     removed monument (explain)
- On \_\_\_\_\_ placed a \_\_\_\_\_  
DATE

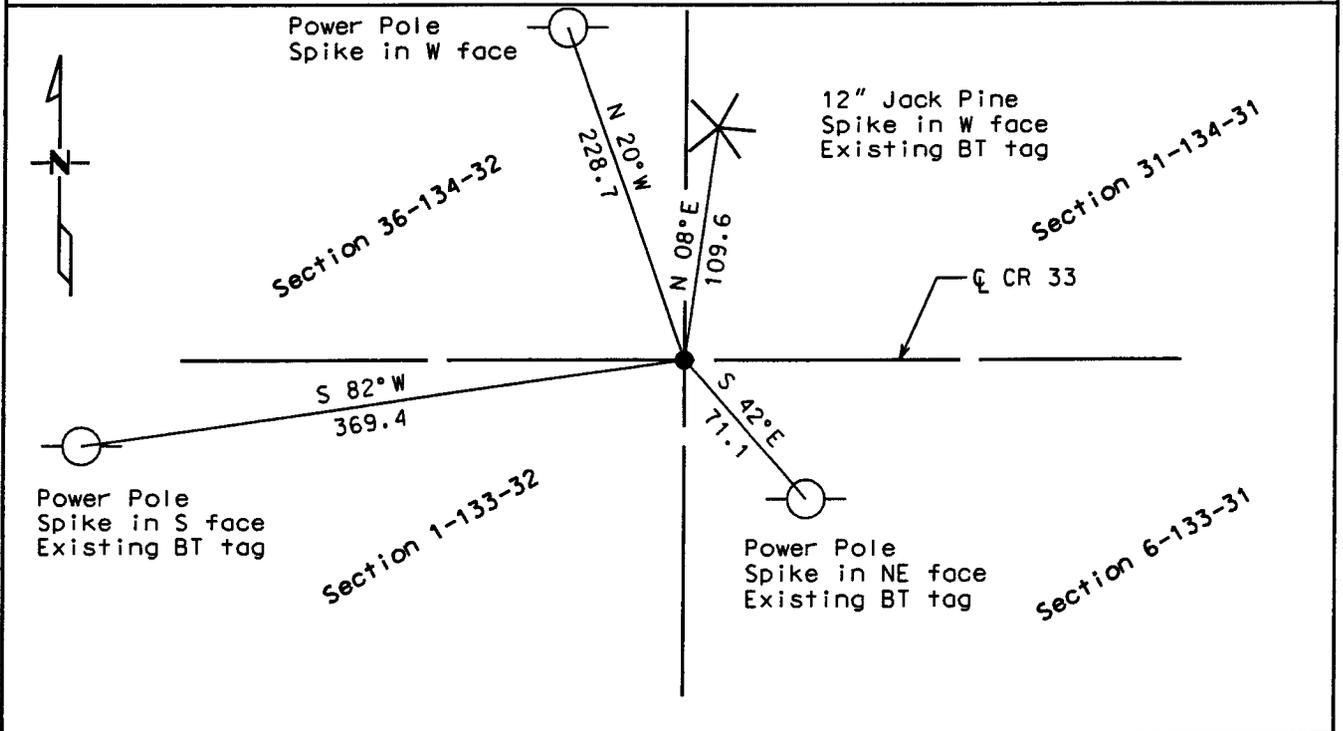

Statement of evidence for this corner location is on back of this page.

I hereby certify that this document was researched and prepared by me or under my direct supervision.

Signature *James Klemm* Date 8-16-2006 License No. 23668  
 Title:  Land Surveyor     Professional Engineer     County Surveyor     County Engineer

**Statement of Evidence:** Northeast Corner of Section 1, Township 133, Range 32 West, 5<sup>th</sup> Principle Meridian, Cass County Minnesota.

The Original Government Survey was run in 1858 and a post was set to mark the corner. Bearing ties were made to three Pines and an Aspen tree.

In 1907, Mr. John Curo located two of the bearing trees and set a 8 x 8 x 36 stone monument in cement.

In 2000, the Cass County Surveyor's Office recovered the corner and made bearing ties to a Jack Pine tree and three power poles.

On August 15, 2002, the Cass County Surveyor's Office recovered the corner with an aluminum cap flush in the centerline of County Road 33.

On June 20, 2006, Kramer Leas DeLeo recovered a Telspar Monument. Three existing bearing trees were recovered and a bearing tree tie was made to a power pole. Kramer Leas DeLeo accepts this as the correct location for the corner.

For details and survey analysis contact Kramer Leas DeLeo in Brainerd, Minnesota.