

CERTIFICATE OF LOCATION OF GOVERNMENT CORNER

E1/4 Corner of Section 28, Township 137N., Range 29W., 5th p.m., State of Minnesota, County of Cass


At the corner location shown on the sketch:

On 04/09/2012 found 2006 REFERENCE TIES (NW AND SE), NO CORNER FOUND
Date

left monument as found lowered monument removed monument (explain)

On 04/12/2012 placed a 3/8" RE-ROD WITH RLS CAP NO. 17774
Date

SKETCH OF REFERENCE TIES

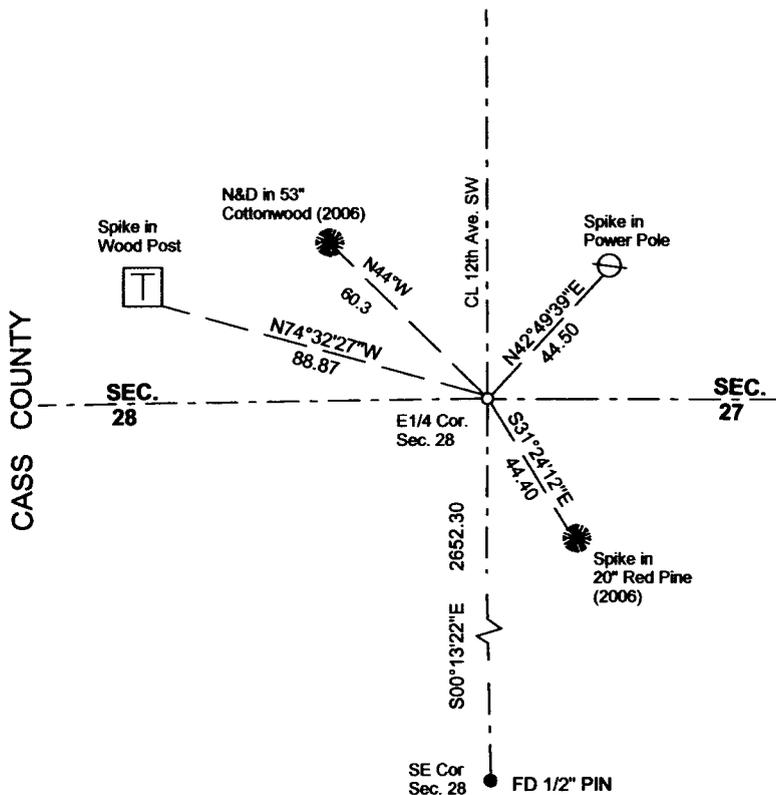

Tie Distances are measured to the spikes.

Cass County Coordinate System (South Zone)
N=281198.8260 E=530463.9140

- o Set Re-Rod with RLS cap No. 17774
- Found pipe (Unless otherwise noted)

T Telephone pedestal/Wood Post

CROW WING COUNTY



NOT TO SCALE

Statement of evidence relative to this corner location is on back of page.

I hereby certify that this document and the data contained herein was prepared by me or under my direct supervision.

Marvin R. Kohout 27 SEPT 2012
Marvin R. Kohout Date

Registration No. 17774

Land surveyor

OFFICE OF COUNTY RECORDER



A000591522

OFFICE OF THE COUNTY RECORDER
CASS COUNTY, MINNESOTA
CERTIFIED, FILED, AND/OR
RECORDED ON

4/15/2013 10:52:52 AM

AS DOC #: A000591522
PAGES: 2
REC FEES: 0.00

KATHRYN M. NORBY
CASS COUNTY RECORDER

BY SR Dep



STATEMENT OF EVIDENCE:

EAST QUARTER CORNER OF SECTION 28, TOWNSHIP 137 N., RANGE 29 W.

- 1865 JULY DEPUTY SURVEYOR THOMAS B. WALKER, IN THE ORIGINAL GOVERNMENT SURVEY, SET A POST AND MARKED BEARING TREES.
- 1908 DEC. J. CURO, SURVEYOR, SET A 7/8" DIA. IRON MIDWAY BETWEEN THE SOUTHEAST CORNER AND THE NORTHEAST CORNER. SURVEY RECORD BOOK "A" PAGES 318-328
- 1932 J. CURO FOUND A 3/4 INCH IRON PIPE "HE SET 25 YEARS AGO". BOOK NO. 164 PAGES 48, 53
- 1996 DAVID LANDECKER, LS NO. 17008, LANDECKER AND ASSOC.'S, INC., ON HIS CERTIFICATE OF SURVEY OF PART OF THE SE1/4, INDICATES HE FOUND A MONUMENT.
- 1998 LANDECKER, LS NO. 17008, ON HIS CERTIFICATE OF SURVEY, INDICATES HE FOUND A MONUMENT. SURVEY RECORD 266
- 2003 PATRICK TROTTIER, LS NO. 41002, LANDECKER AND ASSOC.'S, INC., ON HIS CERTIFICATE OF SURVEY, INDICATES HE FOUND A MONUMENT. SURVEY RECORD 934
- 2006 OCT. JARRETT LEAS, LS NO.42619, KRAMER LEAS DELEO, INC. (KLD), RECORDED CERTIFICATE OF LOCATION OF GOVERNMENT CORNER. (DOC. NO. A000518626) 3 REFERENCE S SHOWN
- 2006 DEC. LEAS, LS NO.42619,KLD, RECORDED THE PLAT OF LONE JACK PINE ON WHICH IS SHOWN A SECTION SUBDIVISION. DOC. NO. A000521343
- 2012 APRIL DOUG STILLE AND MARVIN KOHOUT, LS NO. 17774,, OF KOHOUT LAND SURVEYING, SET A 3/8" RE-ROD WITH RLS CAP NO 17774 AT THE KLD LOCATION OF THE EAST QUARTER CORNER OF SEC. 28, T. 137N., R. 29 W. REFERENCED POWER POLE IN NE QUADRANT(2006) HAS BEEN REPLACED